

**STATE OF UTAH**  
**DEPARTMENT OF NATURAL RESOURCES**  
**DIVISION OF OIL, GAS AND MINING**  
 1594 West North Temple - Suite 1210  
 Box 145801  
 Salt Lake City, Utah 84114-5801  
 Telephone: (801) 538-5340  
 Fax: (801) 359-3940

Incoming  
 m/047/0066  
 April  
 RECEIVED  
 JAN 30 2015  
 DIV. OF OIL, GAS & MINING

**LARGE MINING OPERATIONS PROGRESS REPORT**  
**January 1, 2014 to December 31, 2014**

The information required in this form is based on provisions of the Mined Land Reclamation Act, Title 40-8, and the R647 rules under the Utah Minerals Regulatory Program. It is due January 31 of each year.

1. Mine Permit Number: M470066
2. Mine Name: Diamond Mountain Resources
3. Name of Operator/Permittee: Deseret Generation & Transmission/Diamond Mountain Resources

Note: If Operator's address, company representative, or phone number has changed, please provide a replacement page for the Notice of Intention together with form MR-REV available on the Division's web page at [https://fs.ogm.utah.gov/pub/mines/minerals\\_related/forms/MR-REV.pdf](https://fs.ogm.utah.gov/pub/mines/minerals_related/forms/MR-REV.pdf).

4. Report the gross amount of ore mined and waste moved:

Gross Ore Mined 143,786 Tons, or        yd<sup>3</sup>  
 Waste Material Moved 98,281 Tons, or        yd<sup>3</sup>  
 Disposition of this material: Refer to attached map.

5.
 

New disturbance created during the year	<u>4.9</u>	Acres
Area regraded during the year	<u>0.8</u>	Acres
Area of active operations	<u>18.1</u>	Acres
Total area regraded but not yet fully released	<u>1.9</u>	Acres
Total disturbed area at the end of the year	<u>20.0</u>	Acres*


\*The total disturbed area includes areas of active operations and regraded and seeded areas that have not been fully released. It should not be greater than the permitted/bonded acreage.

6. Briefly describe the reclamation work performed during the past year. (Submit form MR-SITE ([https://fs.ogm.utah.gov/pub/mines/minerals\\_related/forms/MR-SITE.pdf](https://fs.ogm.utah.gov/pub/mines/minerals_related/forms/MR-SITE.pdf)) to apply for full or partial bond/site release). Attach additional sheets if needed.  
Grading and seeding were performed in quadrants F-3, F-4, G-3, and H-3  
(refer to included map).
7. Include an updated map depicting surface disturbance and reclamation performed during the year (Rule R647-4-105).


**I hereby certify the information provided in this report is true and correct to the best of my knowledge and belief.**

Name (Typed or Print): Eric C. Olsen, P.E.

Title of Operator: Environmental Superintendent

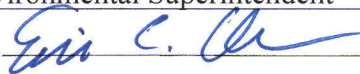Signature of Operator: 

Date: 1-27-2015

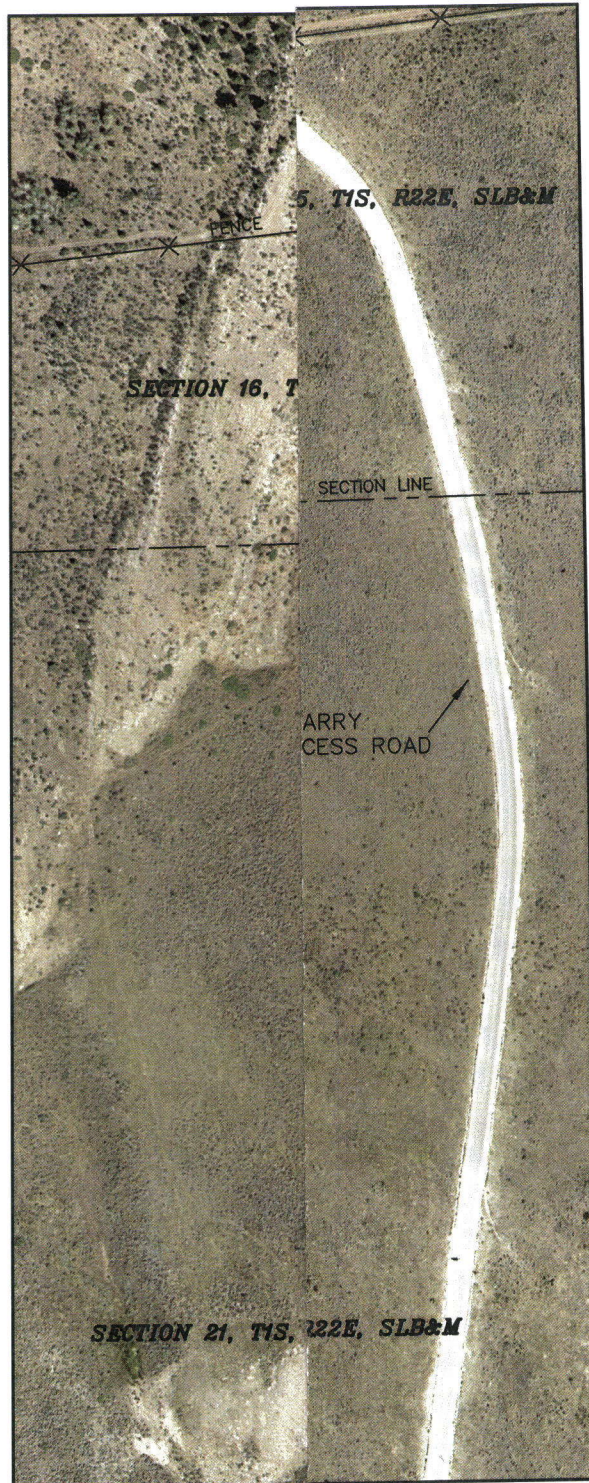

RECEIVED

JAN 30 2015

DIV. OF OIL, GAS & MINING

NOTE:

1. BACKGROUND PHOTO IS OLDER THAN WHAT
2. 2014 WAS A CRUSHING YEAR. IT IS ANTICIPATED THAT THE NEXT CRUSHING YEAR WILL BE 2017.
3. THERE IS NO ANTICIPATED SURFACE DISTURBANCE IN 2015. ALL DISTURBED AREAS THAT ARE NOT USED IN THE NEAR FUTURE HAVE BEEN RESECTED.

**POWER**  
ERATIVE

**LIMESTONE QUARRY MAP  
2014 PROGRESS REPORT**

CAD FILE : Quarry Map (1-12-15).dwg

ENGINEERING	BY	DATE	DRAFT	BY	DATE	W.O.
ENG	ECO	1/15	DRAWN	ECO	1/15	DWG.
APVD			CHK			
PLOT SCALE: 1"=250'			APVD			

01122015-1





12500 East 25500 South  
Vernal, Utah 84078  
(435) 789-9000 Fax: (435) 781-5816

January 27, 2015

RECEIVED

JAN 30 2015

DIV. OF OIL, GAS & MINING

State of Utah  
Department of Natural Resources  
Division of Oil, Gas and Mining  
1594 West North Temple, Suite 1210  
PO Box 145801  
Salt Lake City, UT 84114-5801

**Re: Deseret Generation & Transmission/Diamond Mountain Resources' 2014  
Progress Report & 2015's Annual Permit Fee (Permit Number: M470066)**

To Whom It May Concern:

Enclosed are the 2014 Progress Report, updated site map, and \$500 check for 2015's annual permit fee for Diamond Mountain Resources (Permit Number M470066). This mine is operated by Deseret Generation & Transmission.

Please let me know if you have any questions. I can be contacted at 435-781-5706 or [eolsen@deseretpower.com](mailto:eolsen@deseretpower.com).

Sincerely,

A handwritten signature in blue ink, appearing to read "Eric C. Olsen", is written over a horizontal line.

Eric Olsen, P.E.  
Environmental Superintendent

Enclosures (3)